
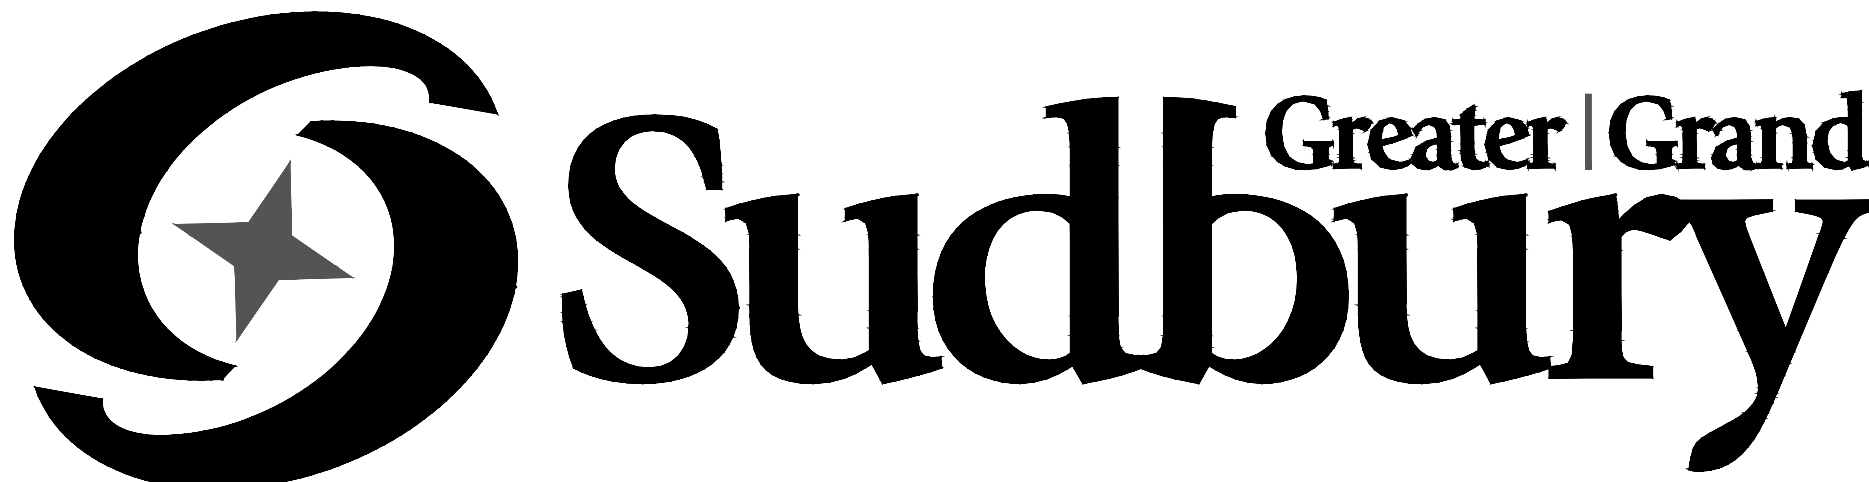


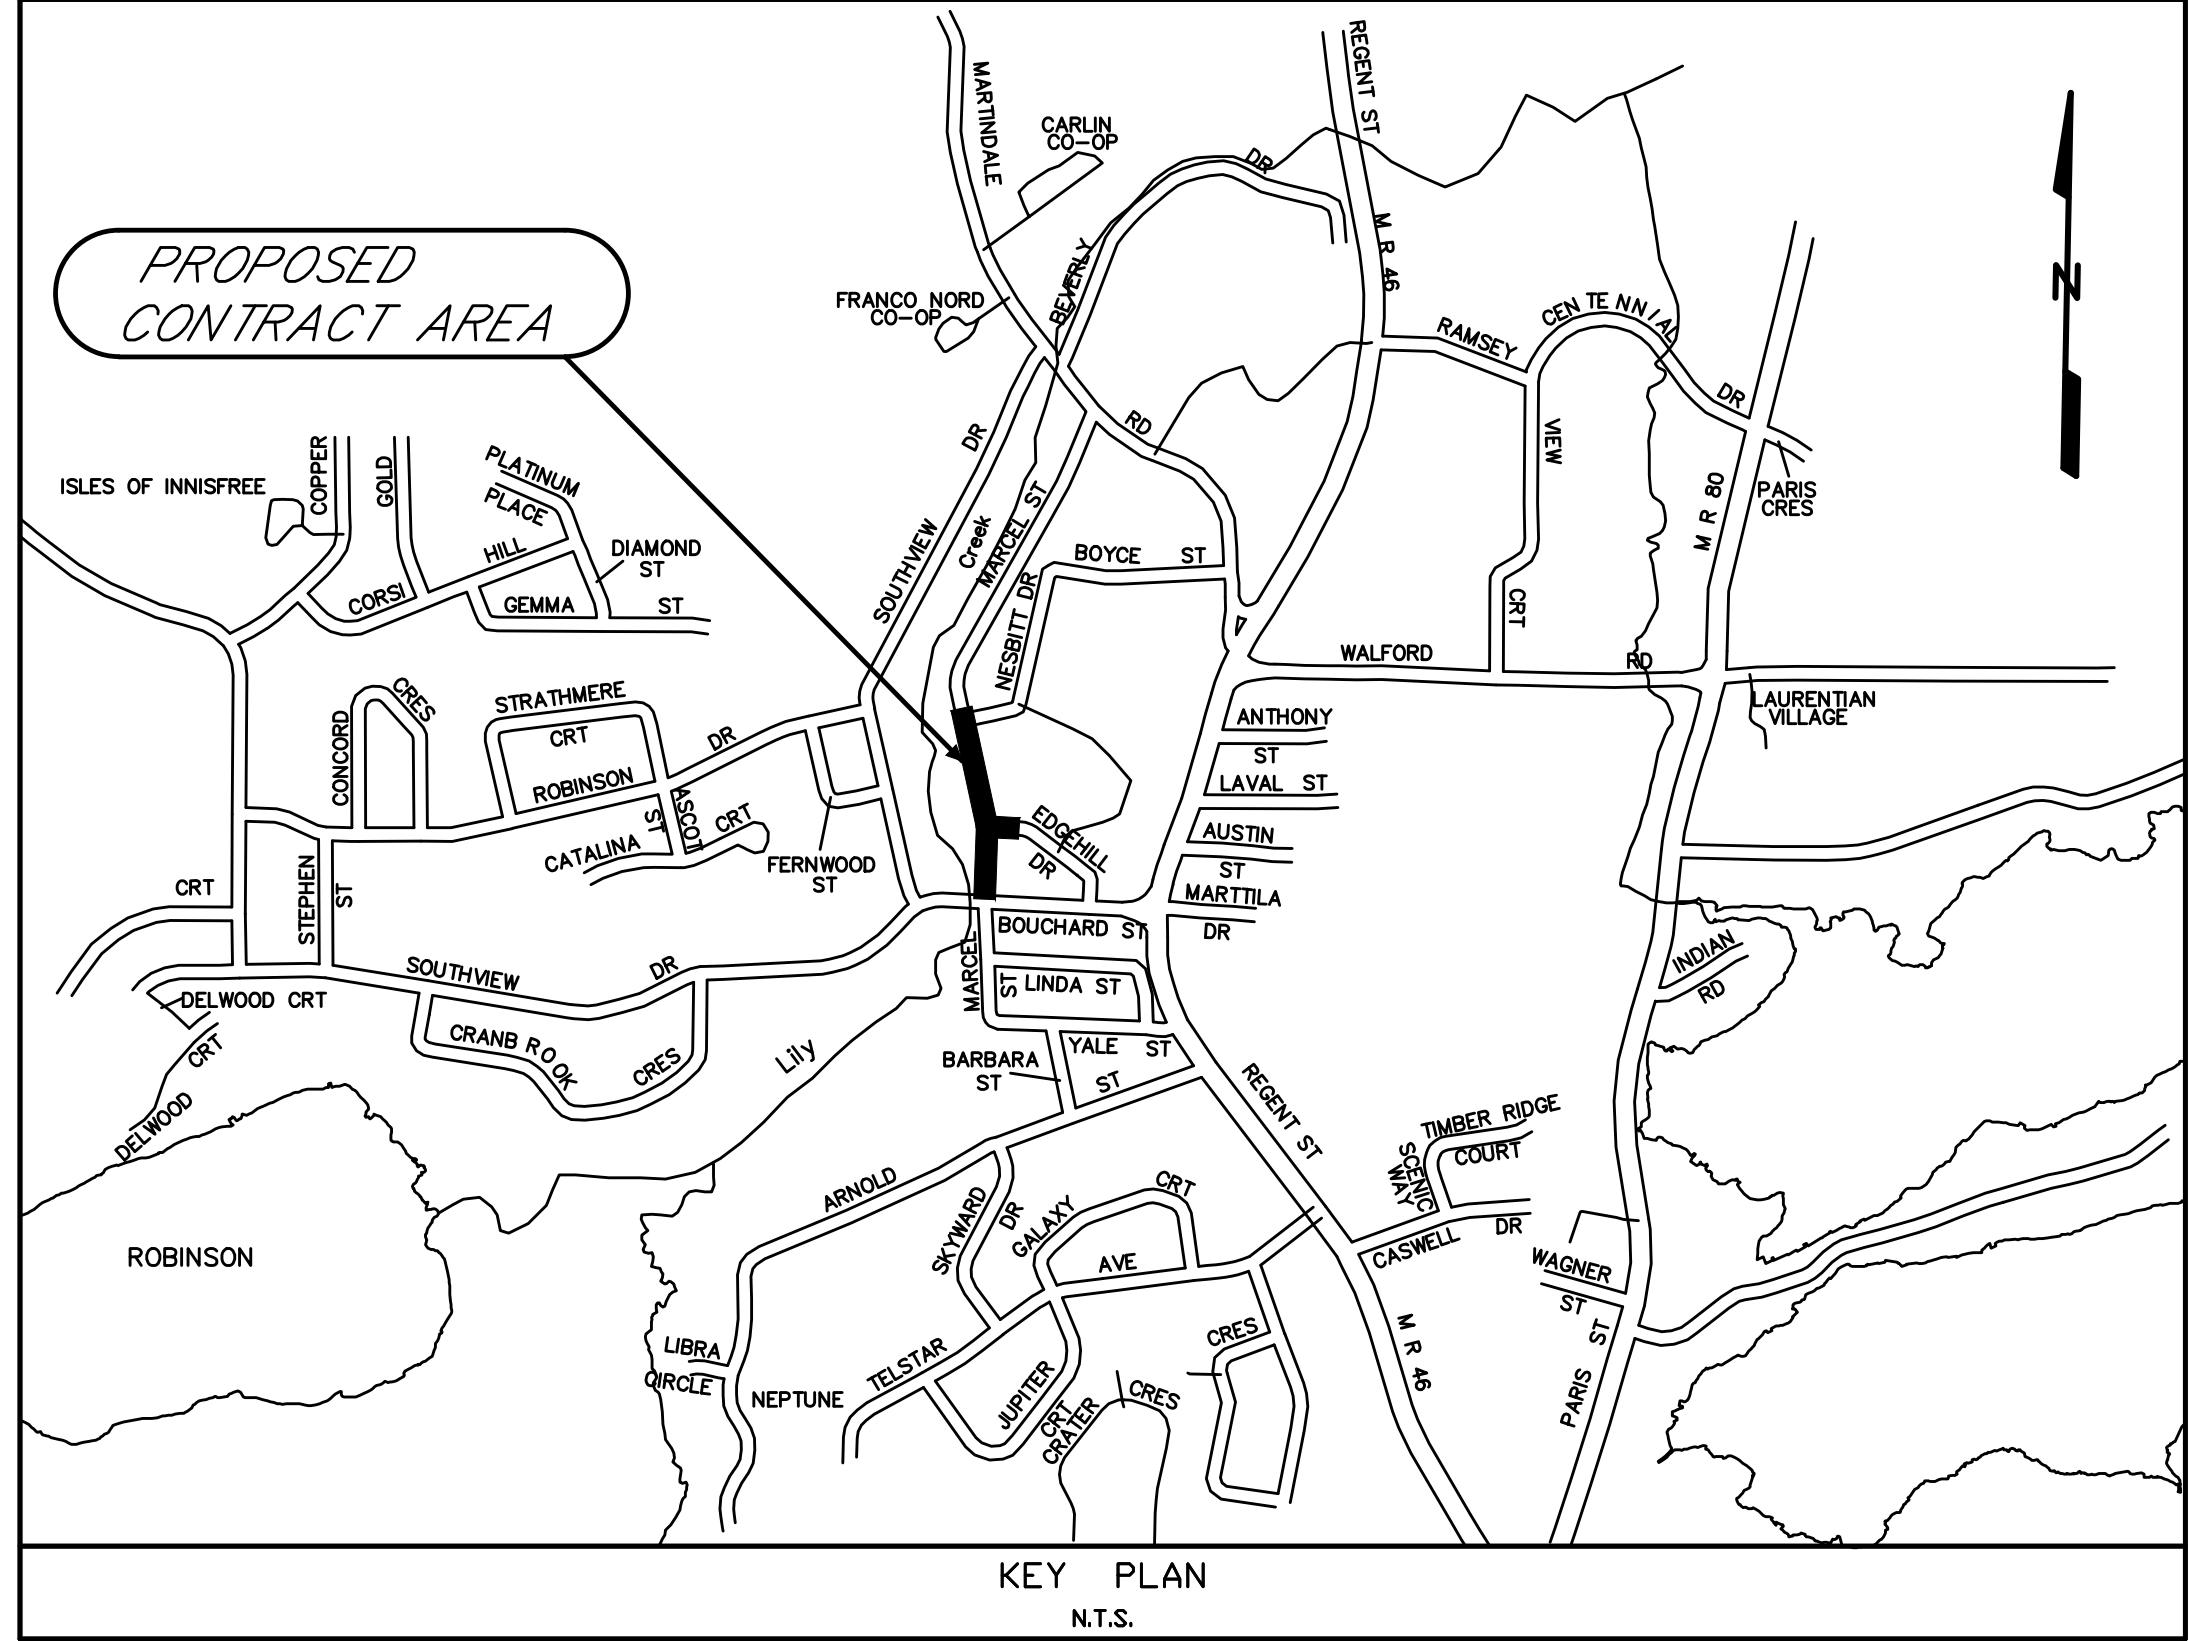

GENERAL MANAGER OF GROWTH & INFRASTRUCTURE

John Brown

Contractor/Author's Signature

Sept. 12/2007

Date

INDEX TO PLANS		
PAGE	DESCRIPTION	PLAN No.
1	COVER SHEET – KEY PLAN & INDEX	C5263–1 (1 OF 1)
2–3	MARCEL STREET – PLAN & PROFILE	C5264–1 & 2 (1 & 2)
4	EDGEHILL DRIVE – PLAN & PROFILE	C5265–1 (1 OF 1)
5	TYPICAL SECTIONS, NOTES & CONSTRUCTION LEGEND	C5266–1 (1 OF 1)


MARCEL STREET



~~PROPOSED RECONSTRUCTION~~

BOUCHARD ST TO NESBITT DR

AS CONSTRUCTED

CONTRACT IES07-18

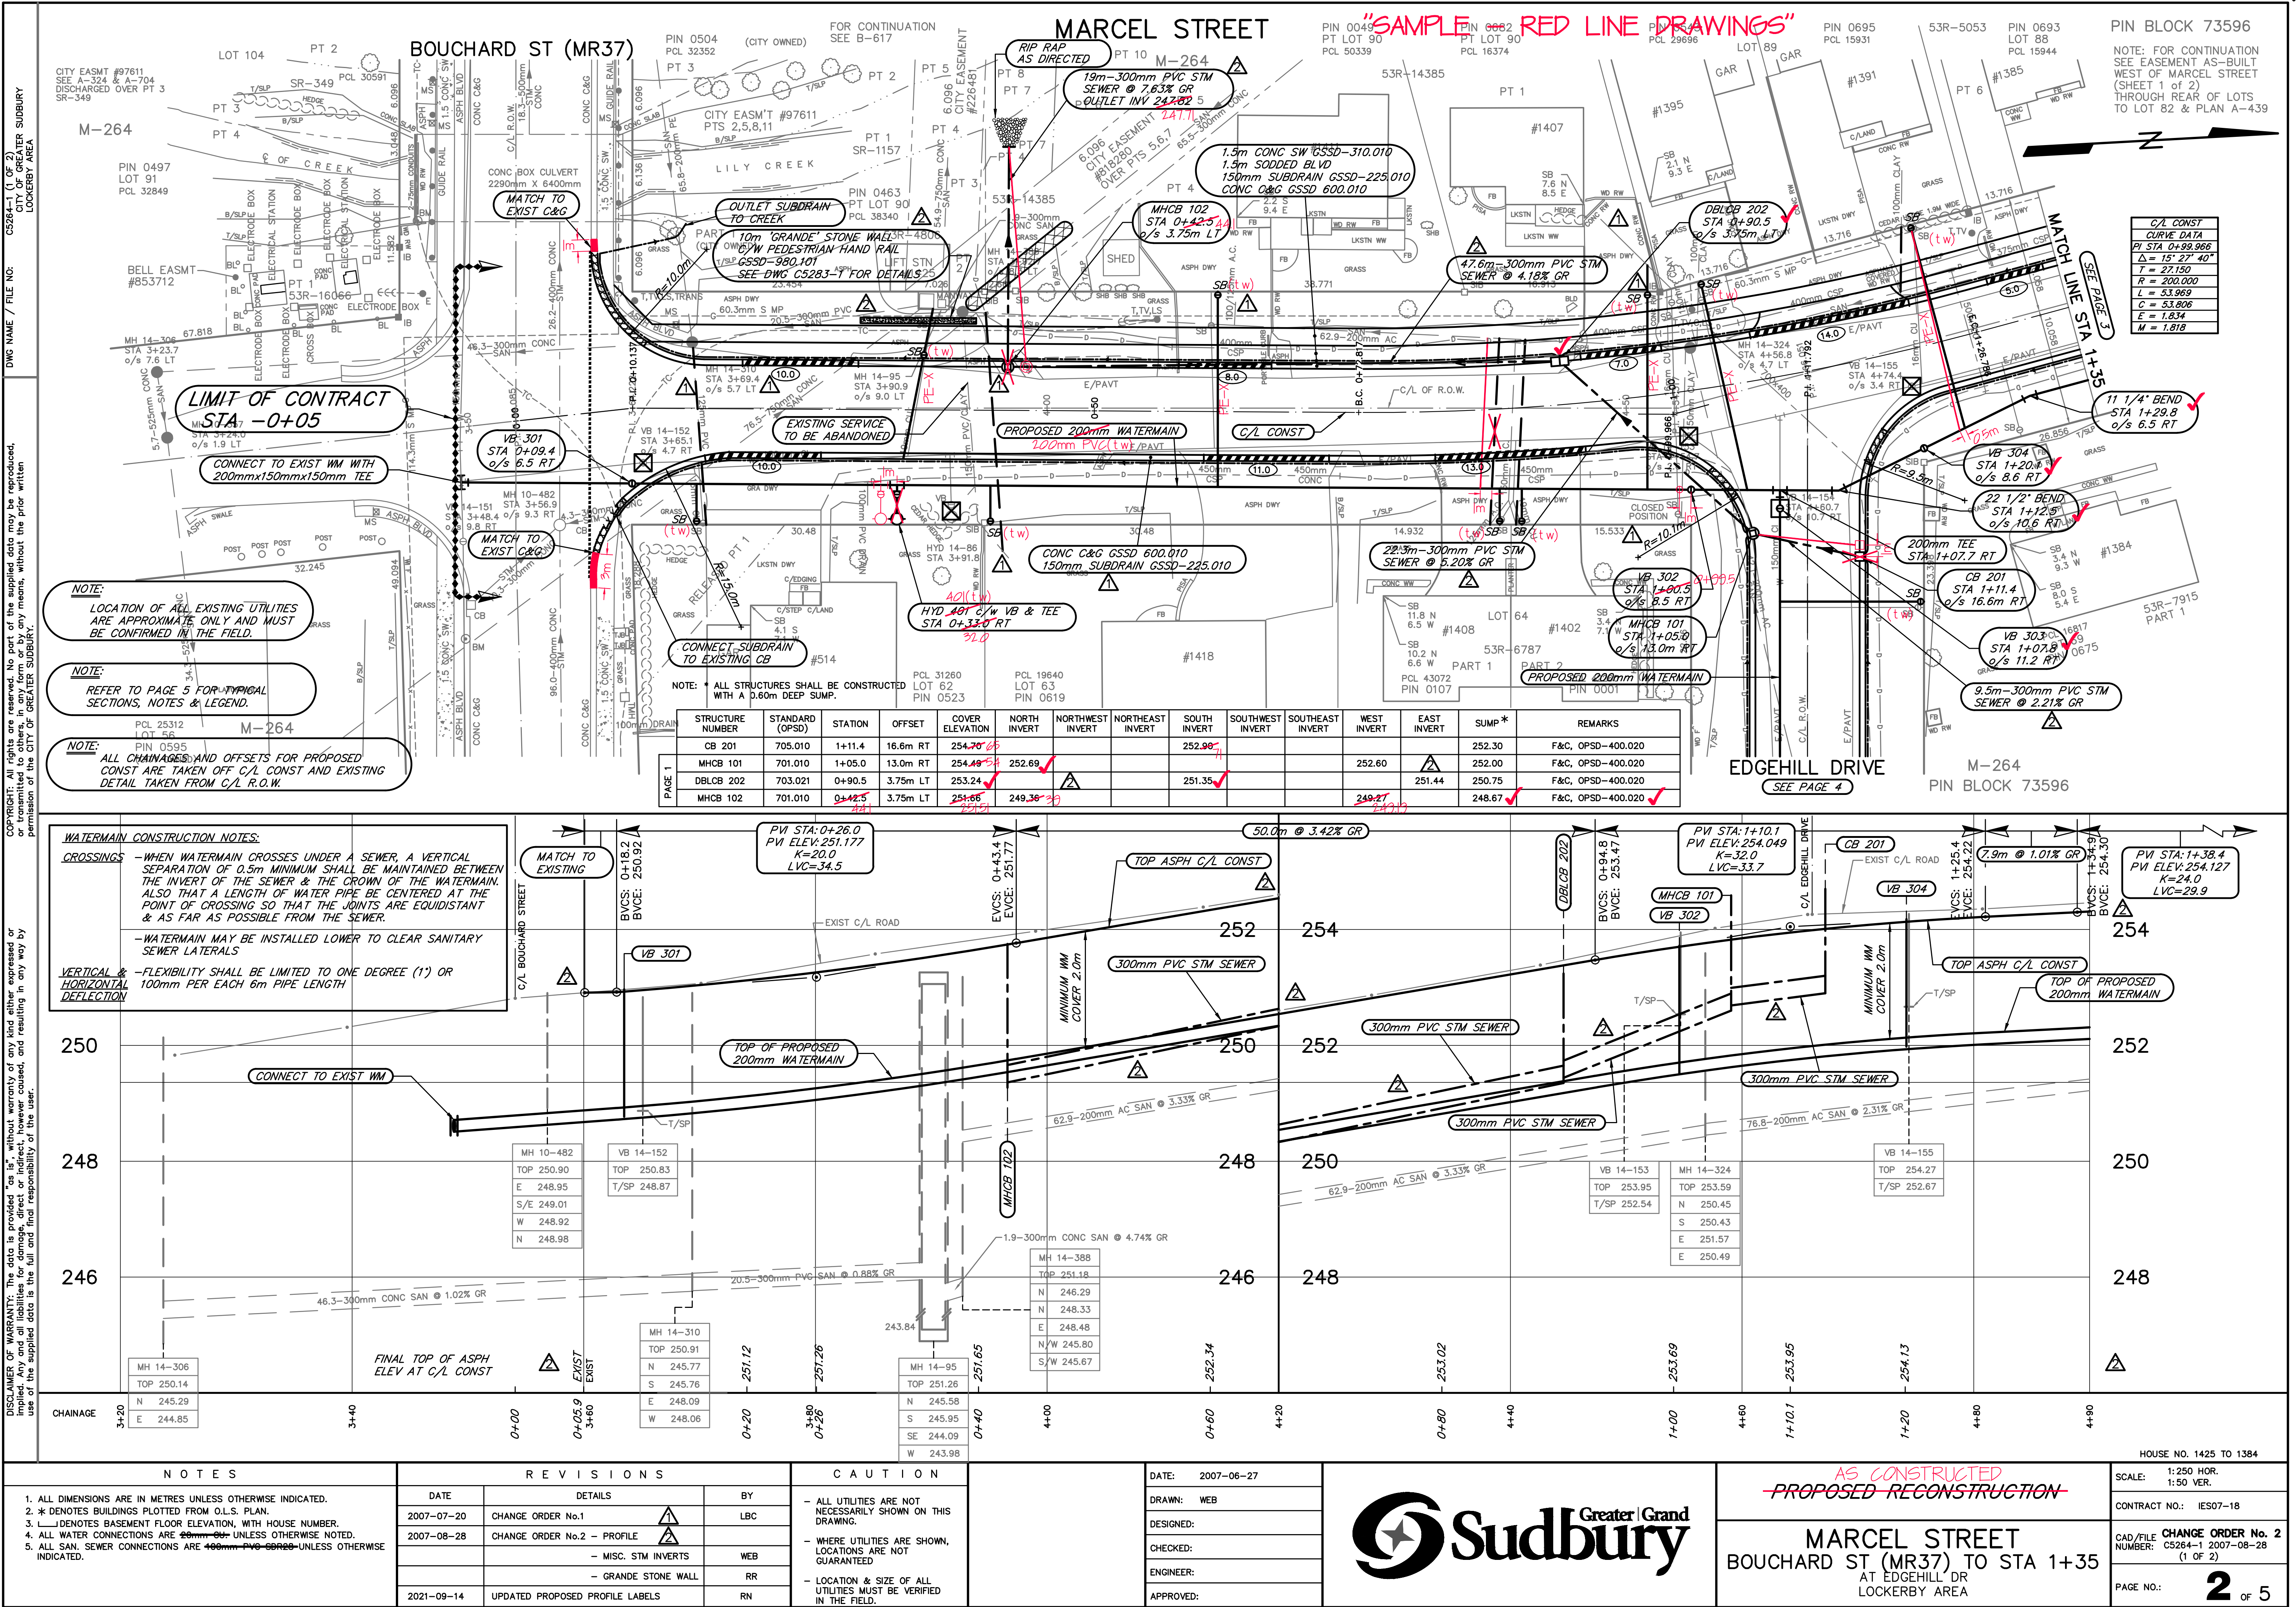

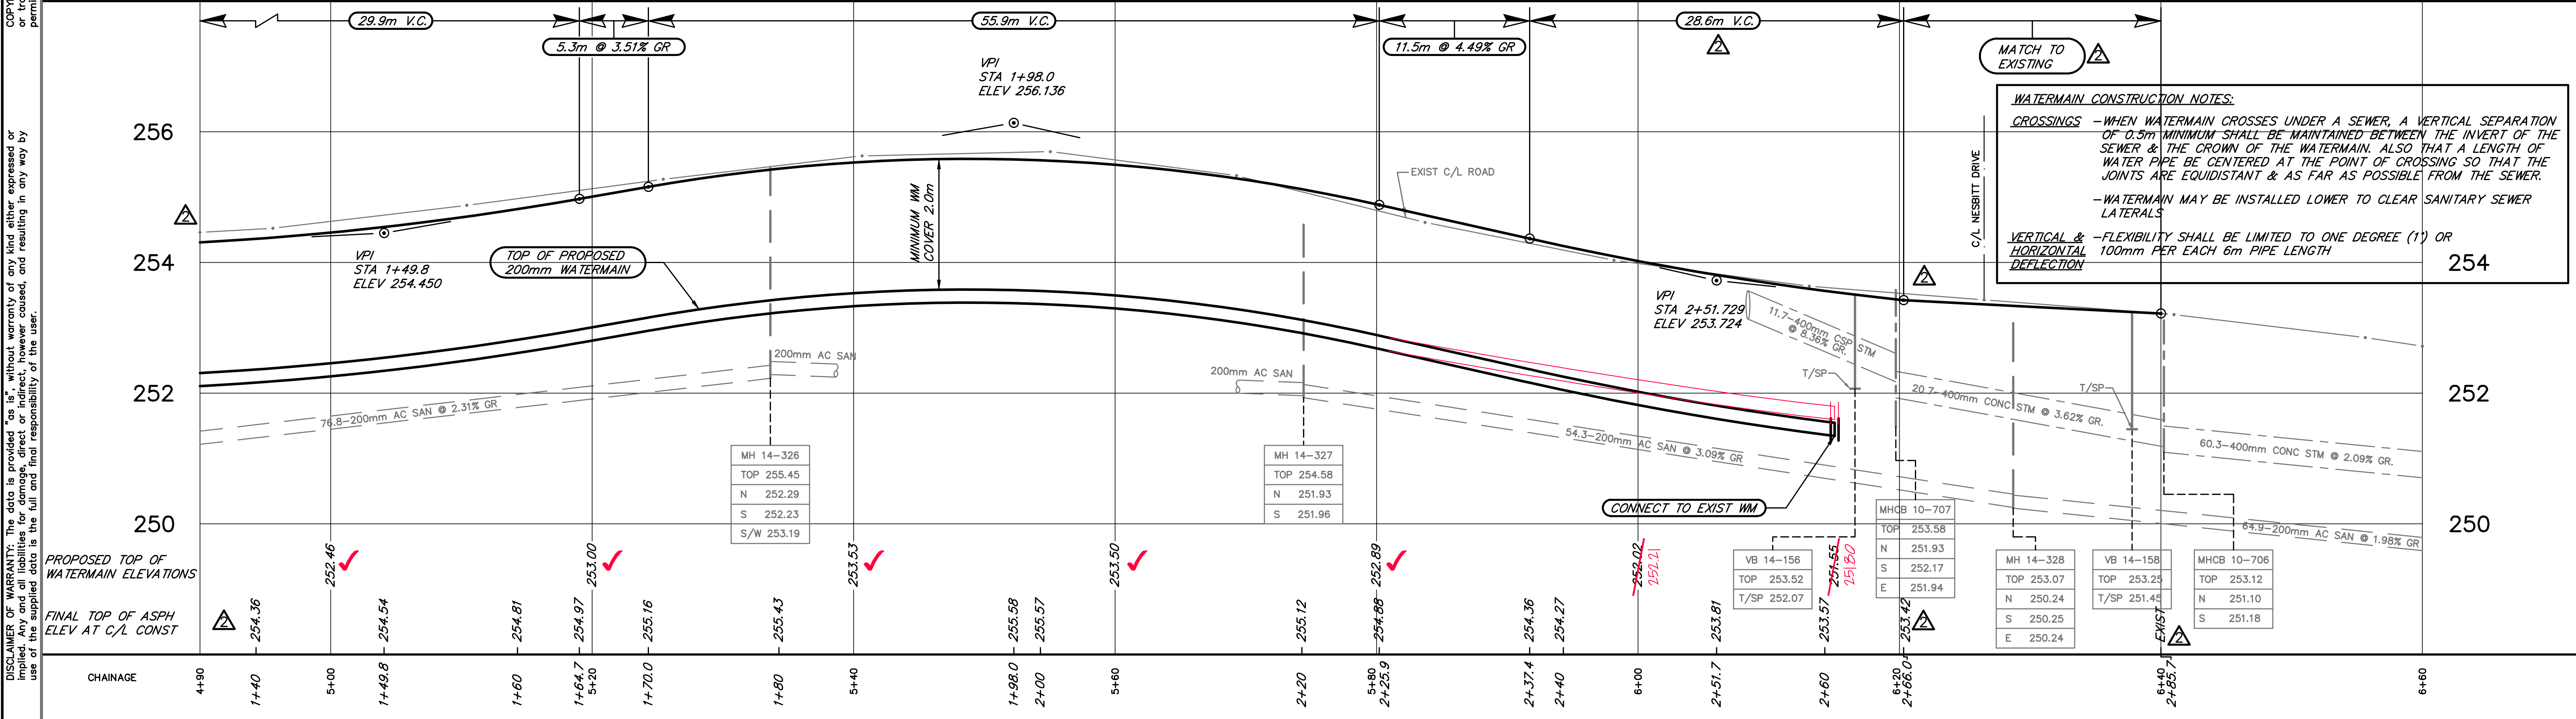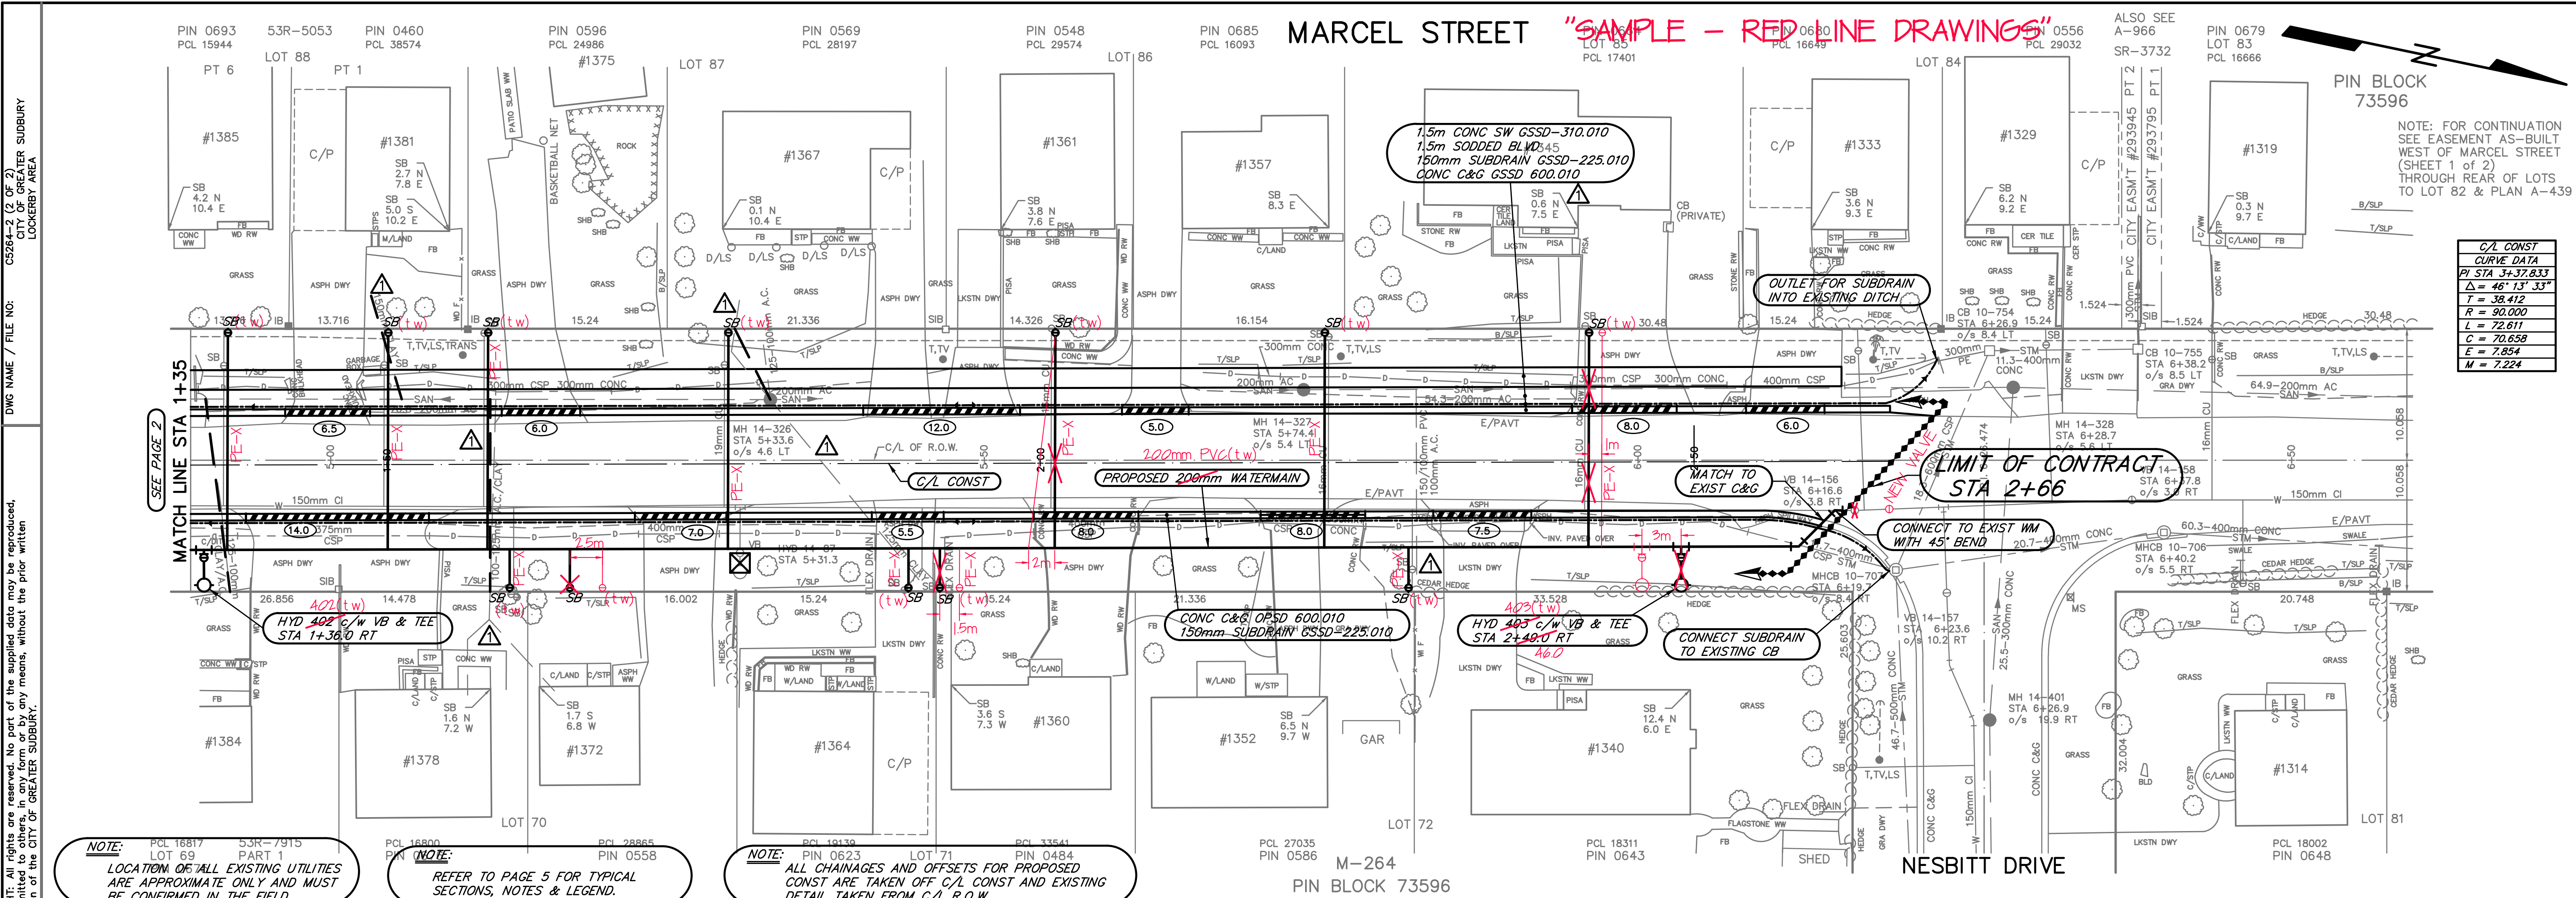

NOTES

- ALL DIMENSIONS ARE IN METRES UNLESS OTHERWISE INDICATED.
- * DENOTES BUILDINGS PLOTTED FROM O.L.S. PLAN.
- DENOTES BASEMENT FLOOR ELEVATION, WITH HOUSE NUMBER.
- ALL WATER CONNECTIONS ARE 400mm PVC C-90 UNLESS OTHERWISE NOTED.
- ALL SAN. SEWER CONNECTIONS ARE 400mm PVC C-90 UNLESS OTHERWISE INDICATED.

REVISIONS

DATE	DETAILS	BY
2007-07-20	CHANGE ORDER No.1	LBC
2007-08-28	CHANGE ORDER No.2 - PROFILE	WEB

CAUTION

- ALL UTILITIES ARE NOT NECESSARILY SHOWN ON THIS DRAWING.
- WHERE UTILITIES ARE SHOWN, LOCATIONS ARE NOT GUARANTEED
- LOCATION & SIZE OF ALL UTILITIES MUST BE VERIFIED IN THE FIELD.

DATE: 2007-06-27

DRAWN: WEB

DESIGNED:

CHECKED:

ENGINEER:

APPROVED:

AS CONSTRUCTED
~~PROPOSED RECONSTRUCTION~~

MARCEL STREET
STA 1+35 TO NESBITT DRIVE

LOCKERY AREA


HOUSE NO. 1384 TO 1314

SCALE: 1:250 HOR.
1:50 VER.


CONTRACT NO.: IES07-18

CAD/FILE NUMBER: CHANGE ORDER No. 2
C5264-2 2007-08-28
(2 OF 2)


PAGE NO.: 3 OF 5

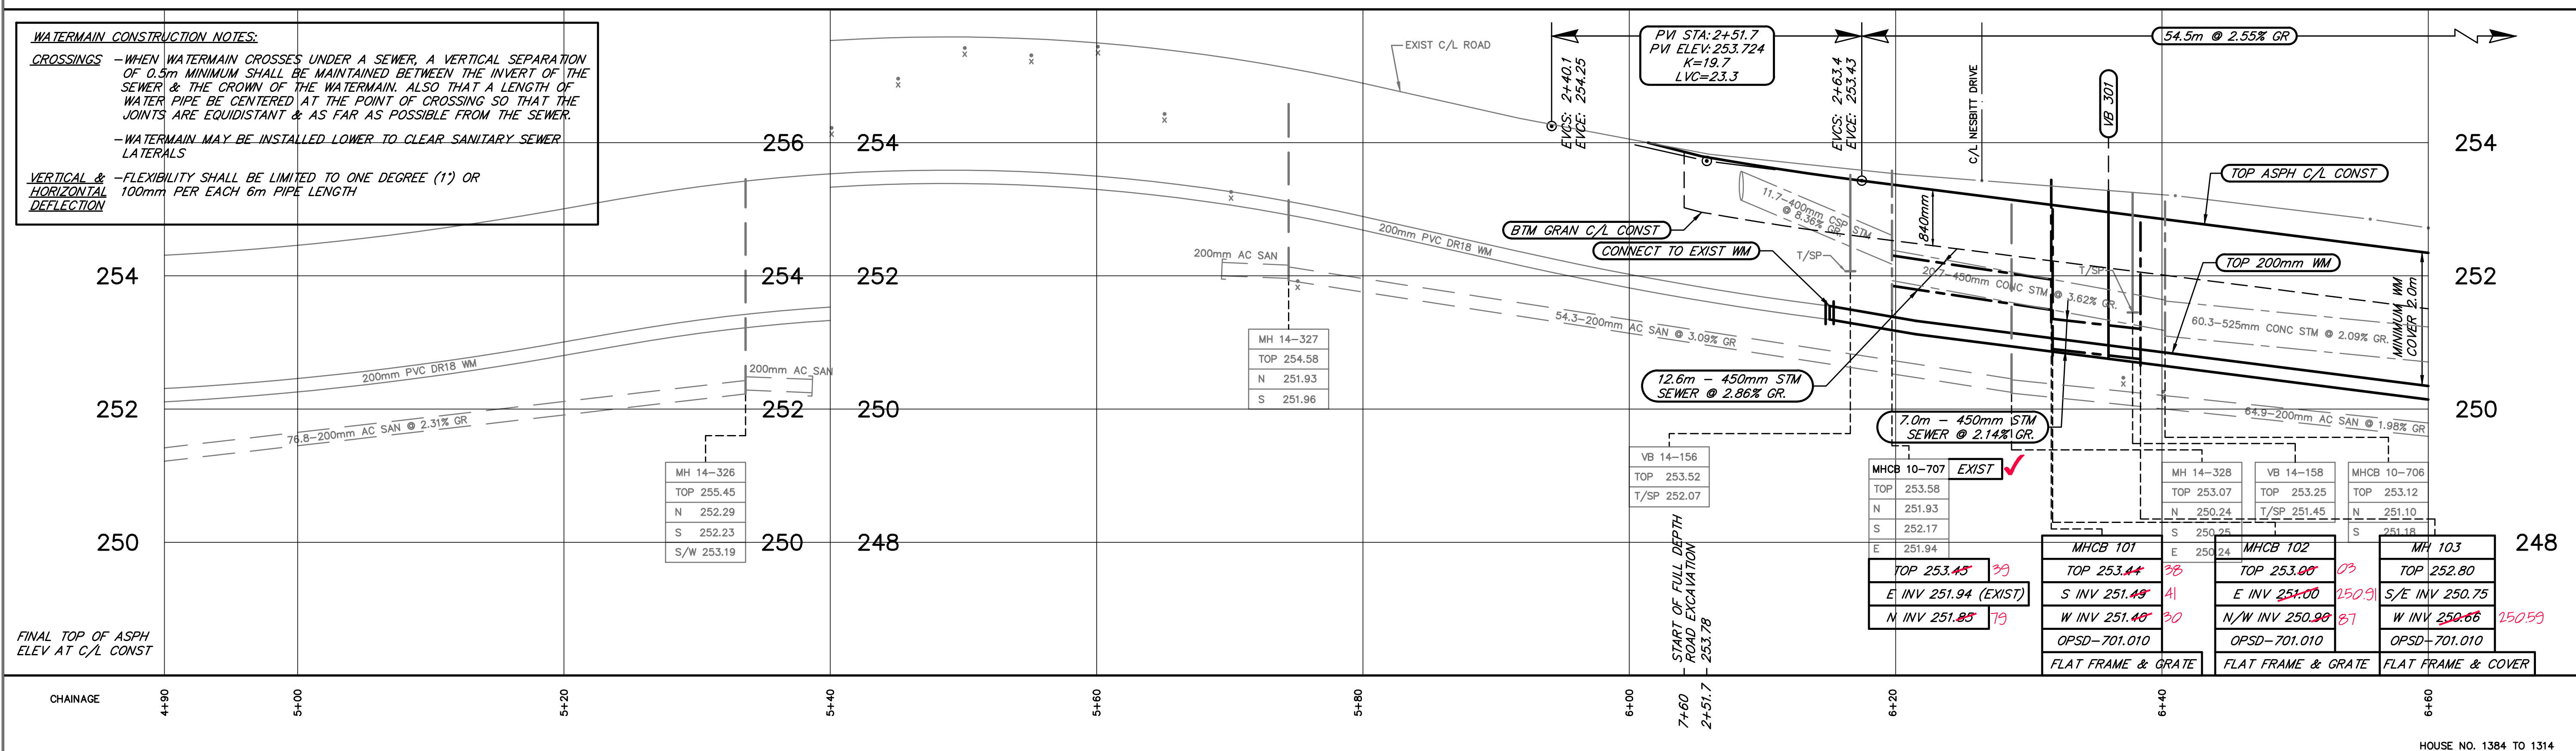


NOTES	REVISIONS					DATE: 2008-03-27		AS CONSTRUCTED PROPOSED RECONSTRUCTION	SCALE: 1:250 HOR. 1:50 VER.
ALL DIMENSIONS ARE IN METRES UNLESS OTHERWISE INDICATED. * DENOTES BUILDINGS PLOTTED FROM O.L.S. PLAN. └─┐ DENOTES BASEMENT FLOOR ELEVATION, WITH HOUSE NUMBER. ALL WATER CONNECTIONS ARE 20mm Ø UNLESS OTHERWISE NOTED. ALL SAN. SEWER CONNECTIONS ARE 100mm PVC CORRUGATED UNLESS OTHERWISE INDICATED. ALL SAN. & STORM SEWER ELEV'S ARE INVERTS UNLESS OTHERWISE NOTED.	DATE	DETAILS	BY			DRAWN: WEB			CONTRACT NO.: ENG008-16
	2021-09-14	UPDATED PROPOSED PROFILE LABELS	RN			DESIGNED:			CAD/FILE NUMBER: C5339-1 (1 OF 4)
						CHECKED:			PAGE NO.: 2 OF 10
						ENGINEER:			
						APPROVED:			

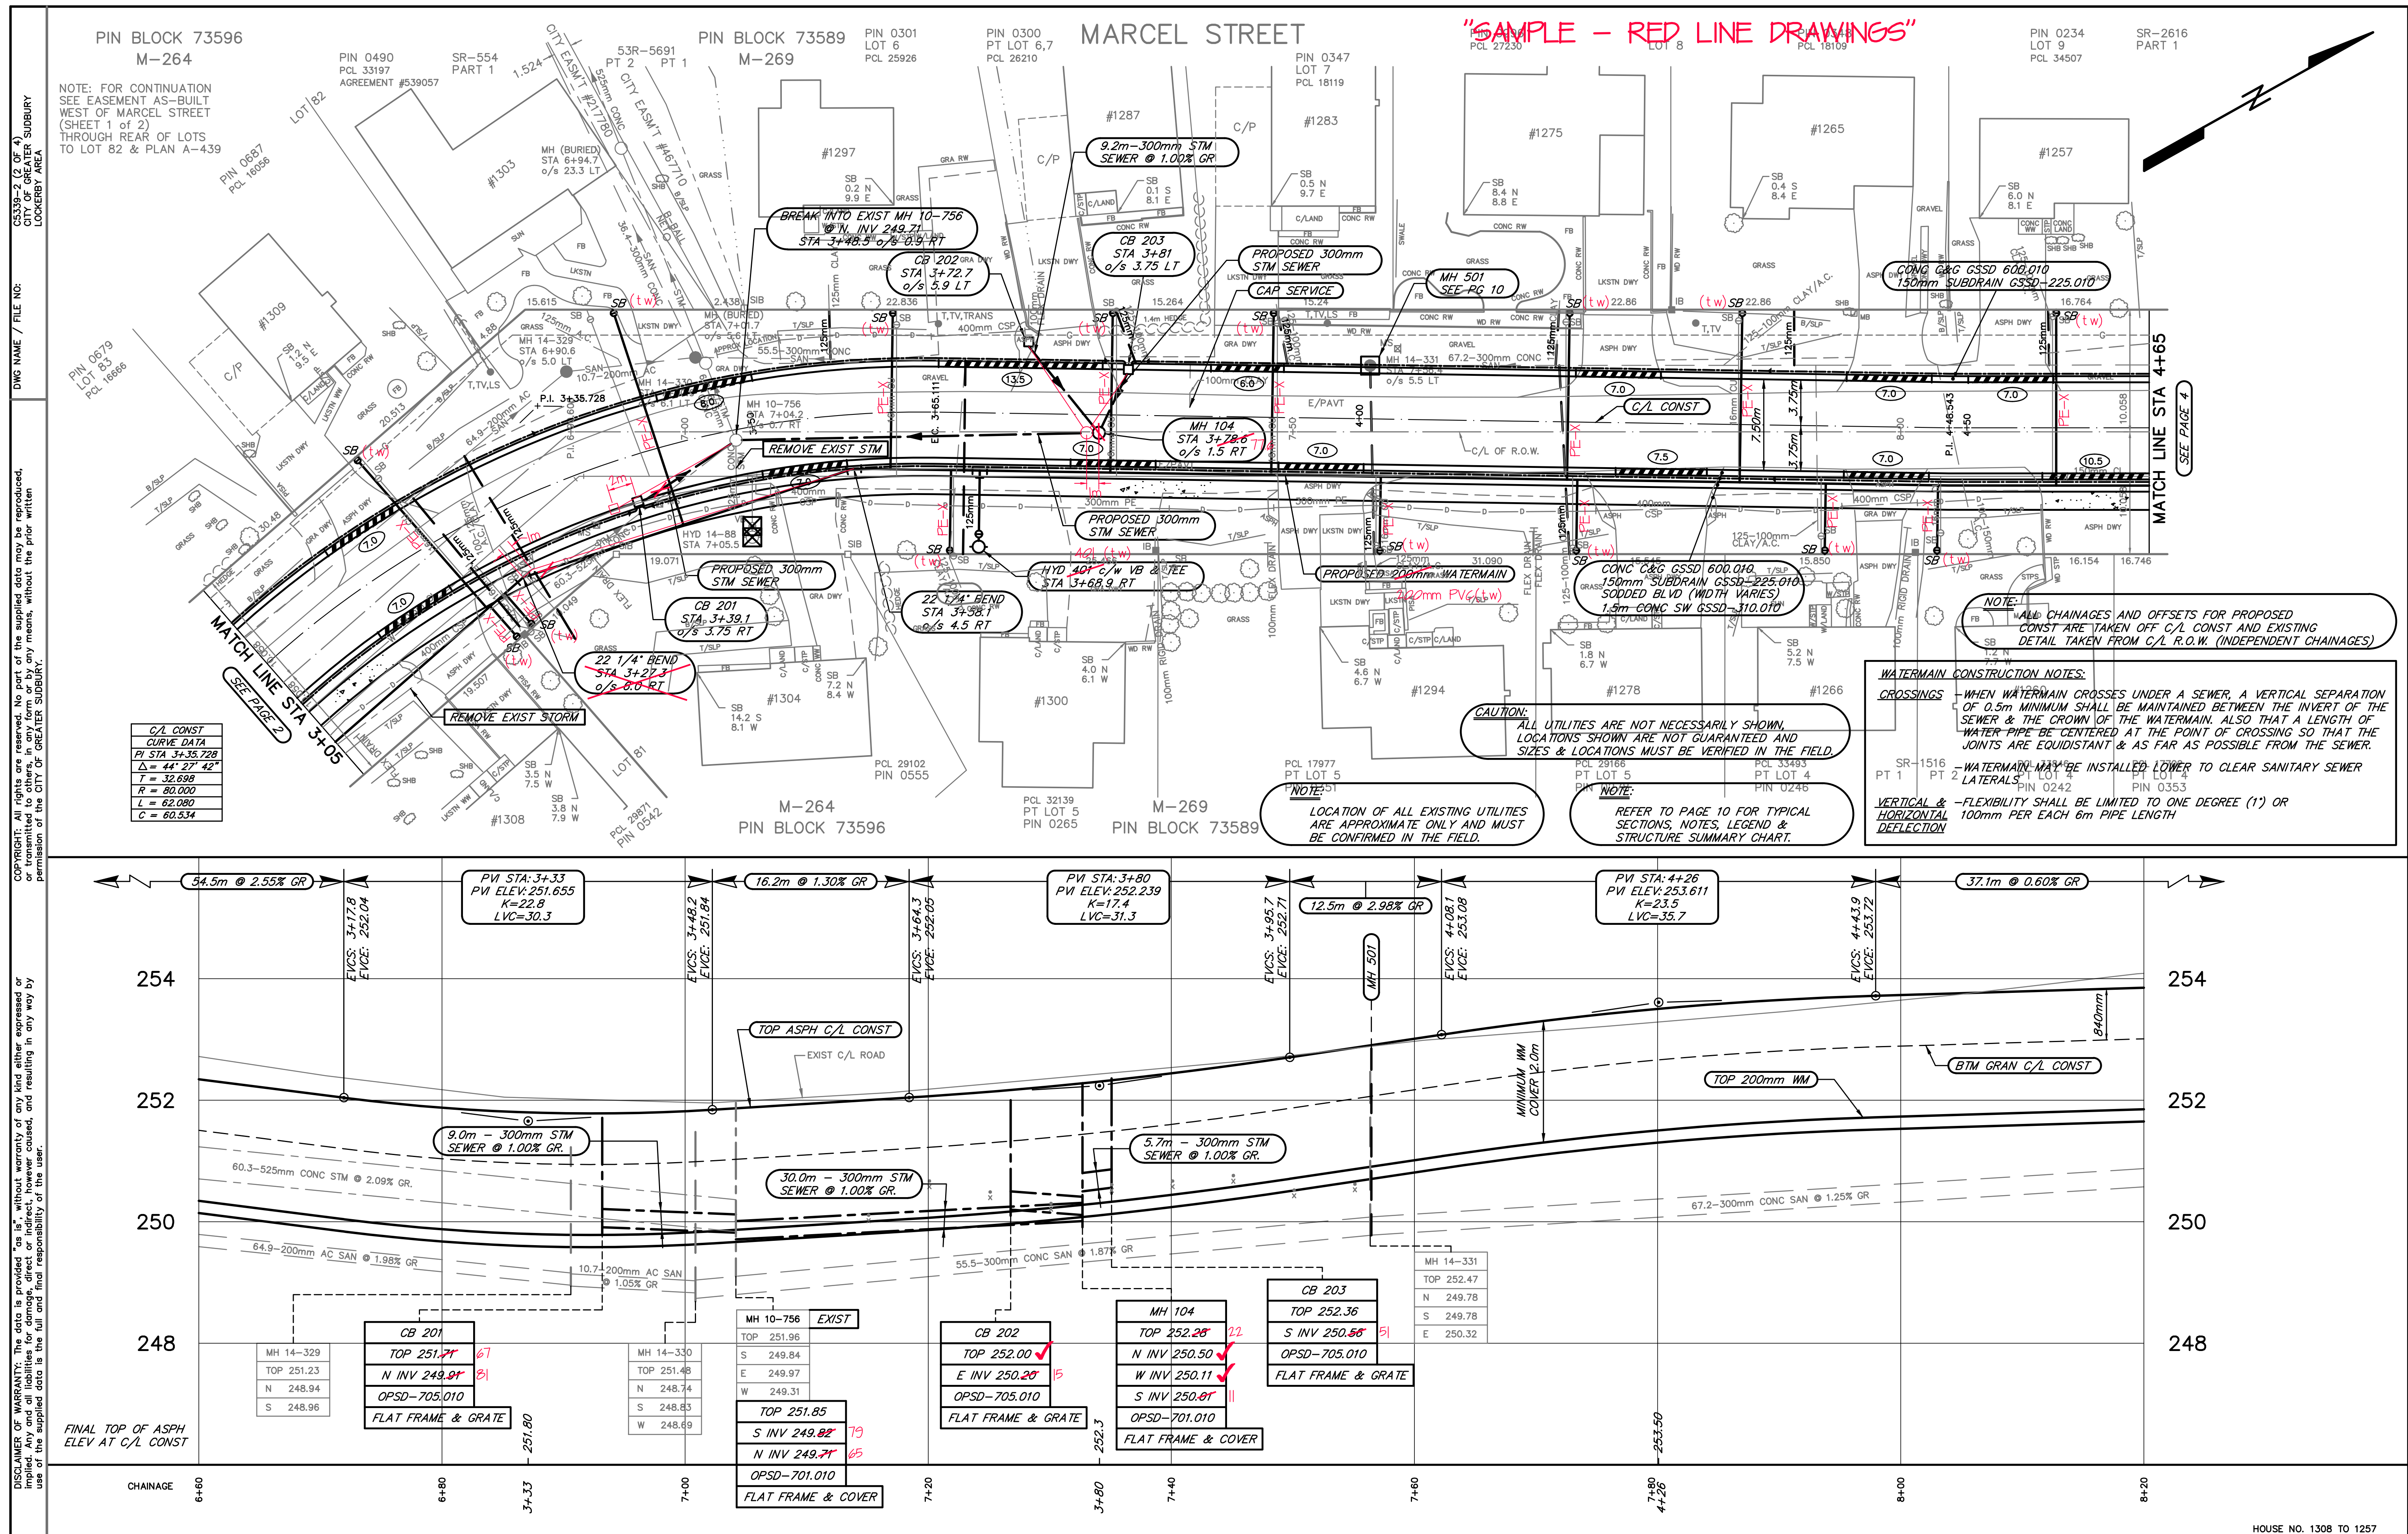

NOTES		REVISIONS			DATE: 2008-03-27			AS CONSTRUCTED PROPOSED RECONSTRUCTION		SCALE: 1:250 HOR. 1:50 VER.	
1. ALL DIMENSIONS ARE IN METRES UNLESS OTHERWISE INDICATED. 2. * DENOTES BUILDINGS PLOTTED FROM O.L.S. PLAN. 3. [] DENOTES BASEMENT FLOOR ELEVATION, WITH HOUSE NUMBER. 4. ALL WATER CONNECTIONS ARE 200mm Ø UNLESS OTHERWISE NOTED. 5. ALL SAN. SEWER CONNECTIONS ARE 400mm PVC Ø UNLESS OTHERWISE INDICATED. 6. ALL SAN. & STORM SEWER ELEV'S ARE INVERTS UNLESS OTHERWISE NOTED.	DATE	DETAILS	BY	DRAWN: WEB	MARCEL STREET STA 3+05 TO STA 4+65 LOCKERBY AREA	CONTRACT NO.: ENG08-16		CAD/FILE NUMBER: C5339-2 (2 OF 4) PAGE NO.: 3 of 10			
	2021-09-14	UPDATED PROPOSED PROFILE LABELS	RN	DESIGNED:							
				CHECKED:							
				ENGINEER:							
				APPROVED:							

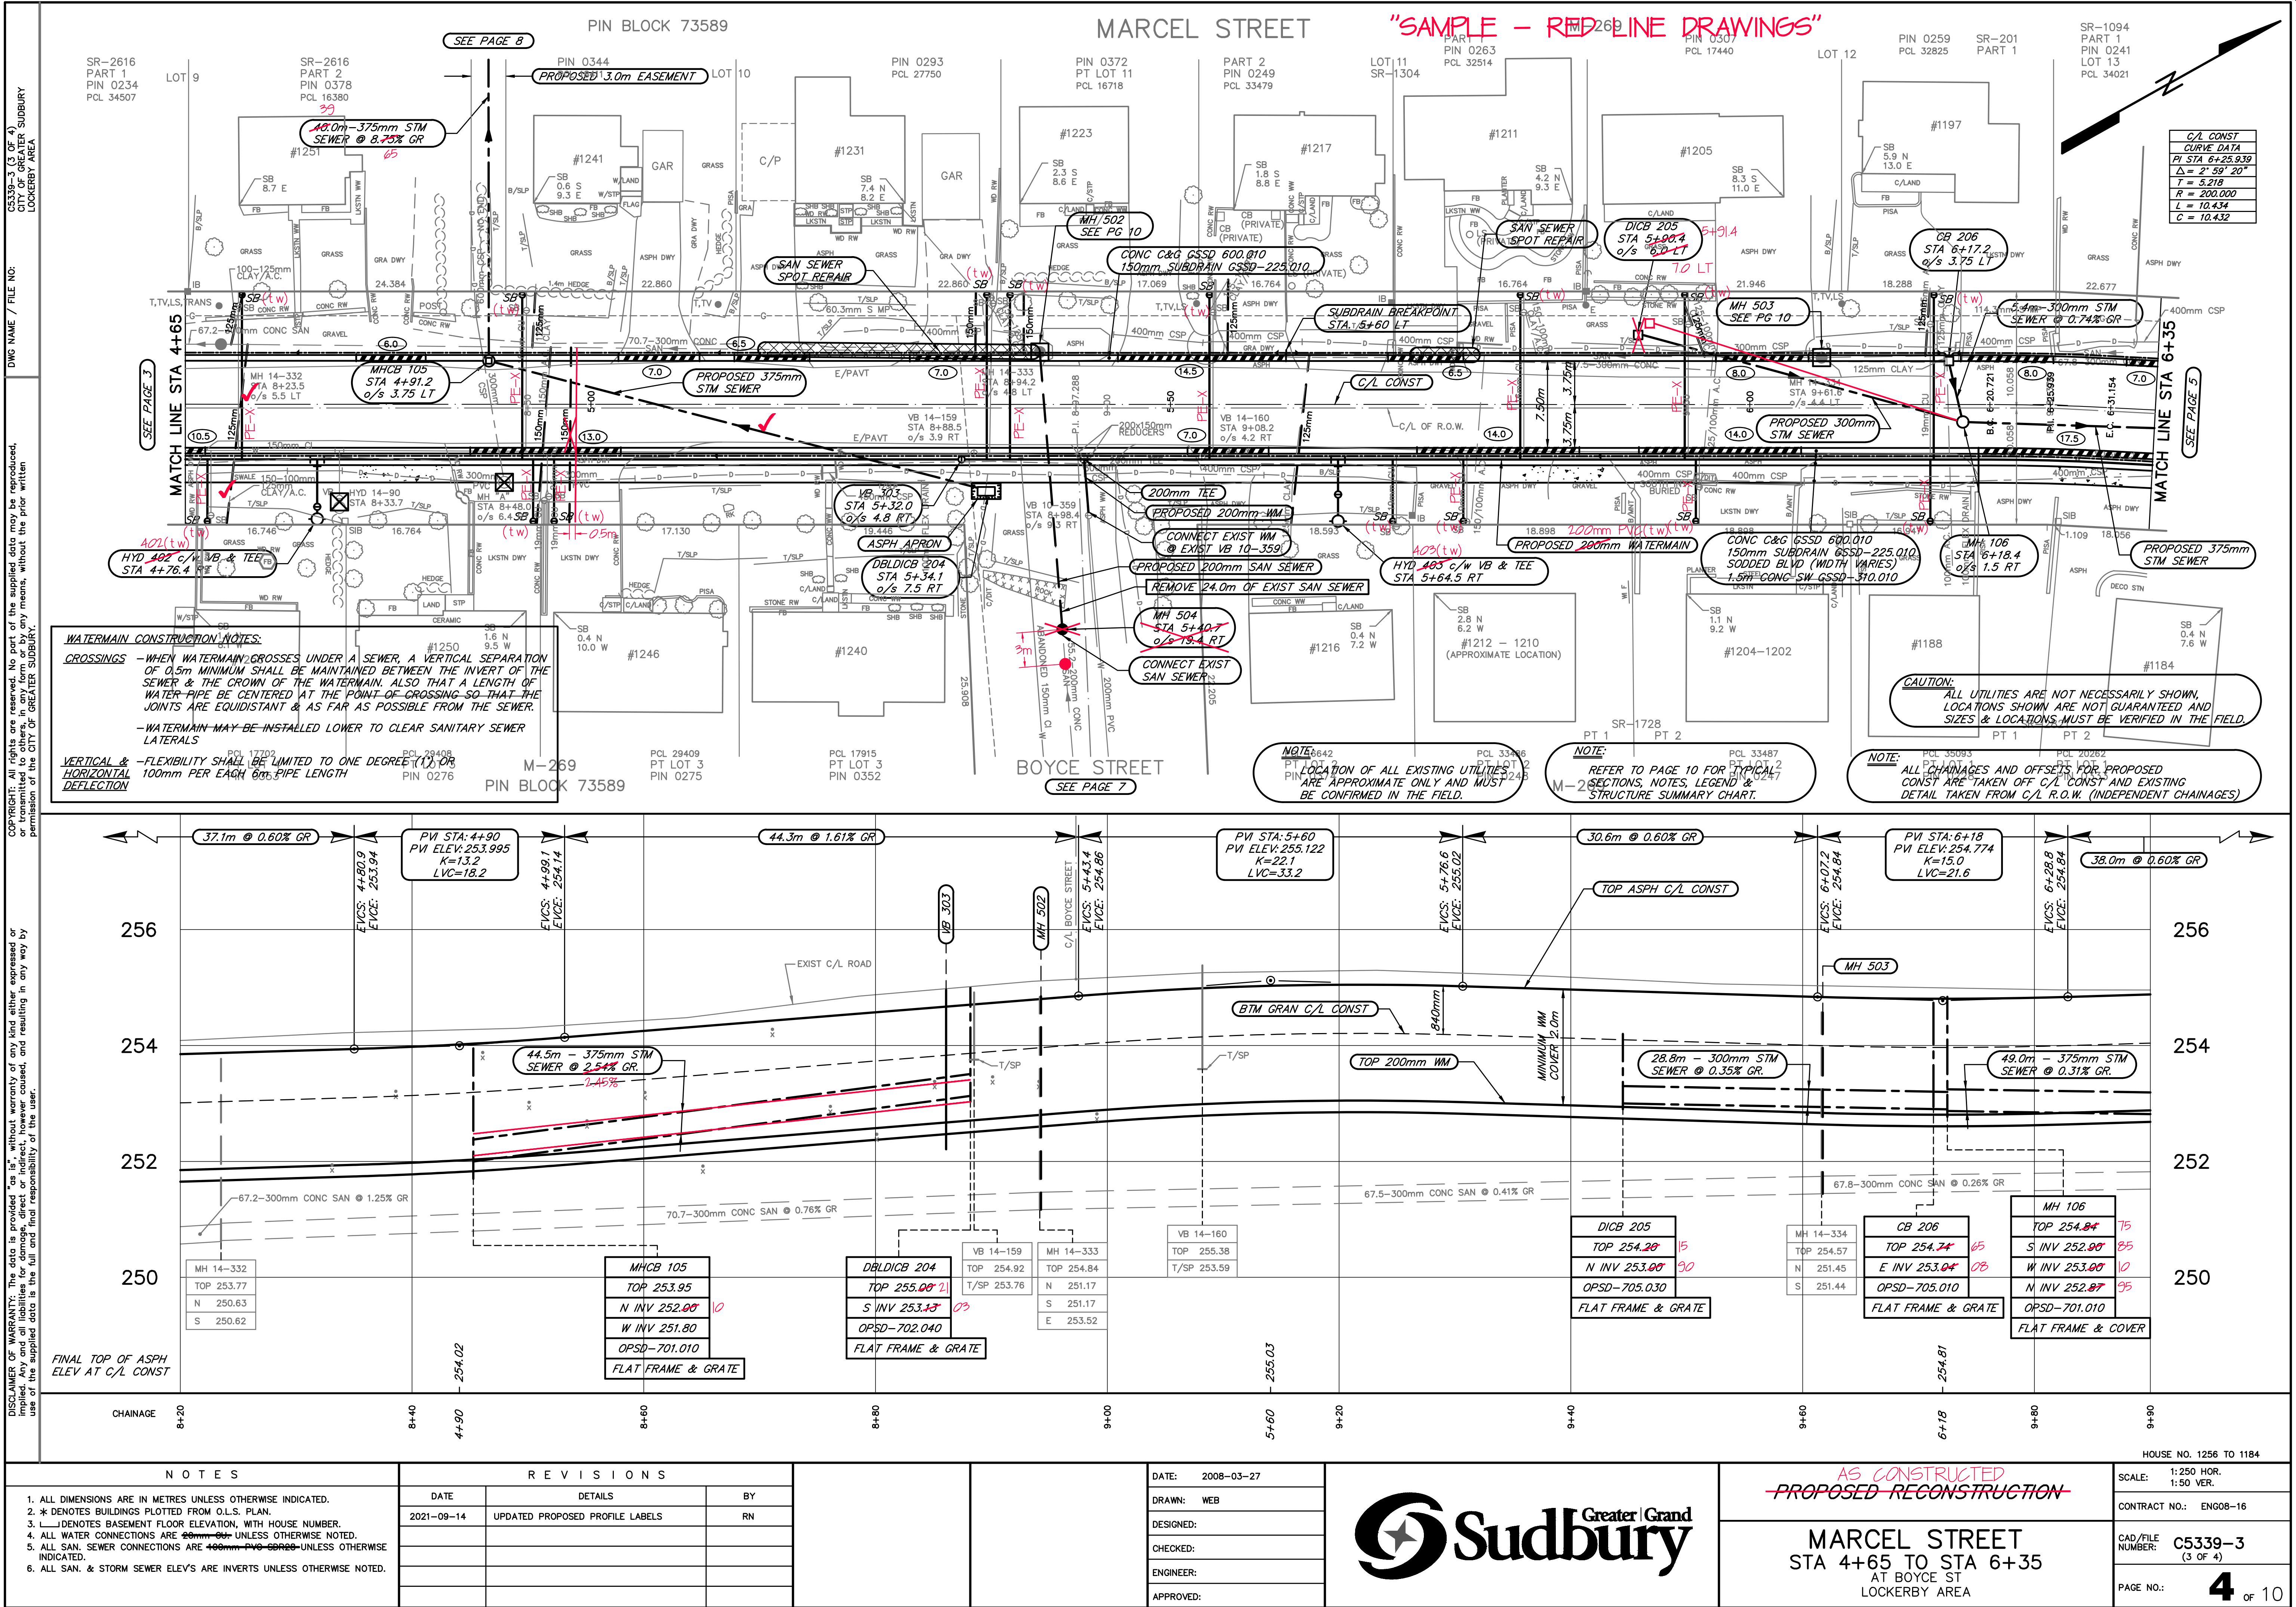

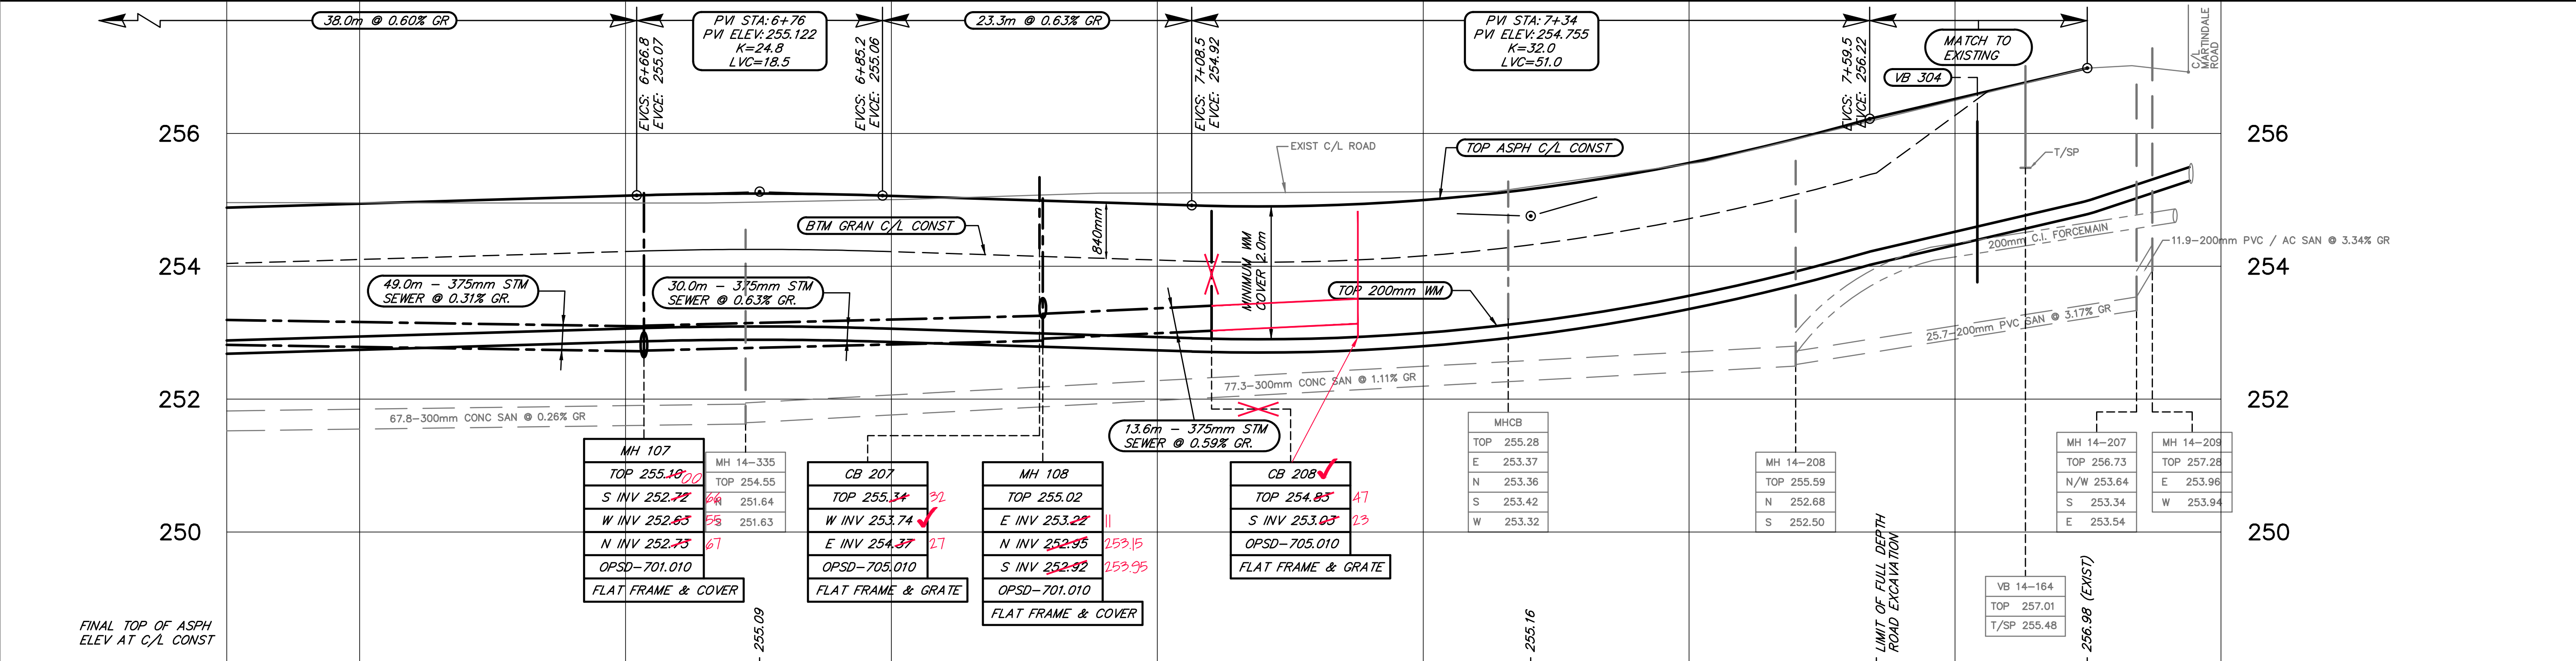

HOUSE NO. 1184 TO 1164	
SCALE: 1:250 HOR. 1:50 VER.	
CONTRACT NO.: ENG08-16	
CAD/FILE NUMBER: C5339-4 (4 OF 4)	
PAGE NO.: 5 OF 10	
AS CONSTRUCTED PROPOSED RECONSTRUCTION	
MARCEL STREET STA 6+35 TO MARTINDALE RD LOCKERBY AREA	
Greater Grand Sudbury	
DATE: 2008-03-27	
DRAWN: WEB	
DESIGNED:	
CHECKED:	
ENGINEER:	
APPROVED:	