

**ISSUED BY:
CITY OF GREATER SUDBURY
ENGINEERING SERVICES DIVISION**

REDLINE DRAWINGS COMPLETED BY:

Name: _____

Title / Organization: _____

Signature: _____

Date: _____

AS CONSTRUCTED


WATERMAIN REPLACEMENT

ST NICHOLAS STREET

WEMBLEY DRIVE TO ST BRENDAN STREET

INDEX TO PLANS		
PAGE	DESCRIPTION	FILE No.
1	COVER PAGE – KEY PLAN & INDEX	CXXX-1
2 TO 3	ST NICHOLAS STREET – PLAN & PROFILE	CXXX-2 TO 3
4	SIDE STREETS – PLAN & PROFILE	CXXX-4
5	TYPICAL SECTIONS, DETAILS, NOTES & LEGEND	CXXX-5

CONTRACT No. ENGXX-X

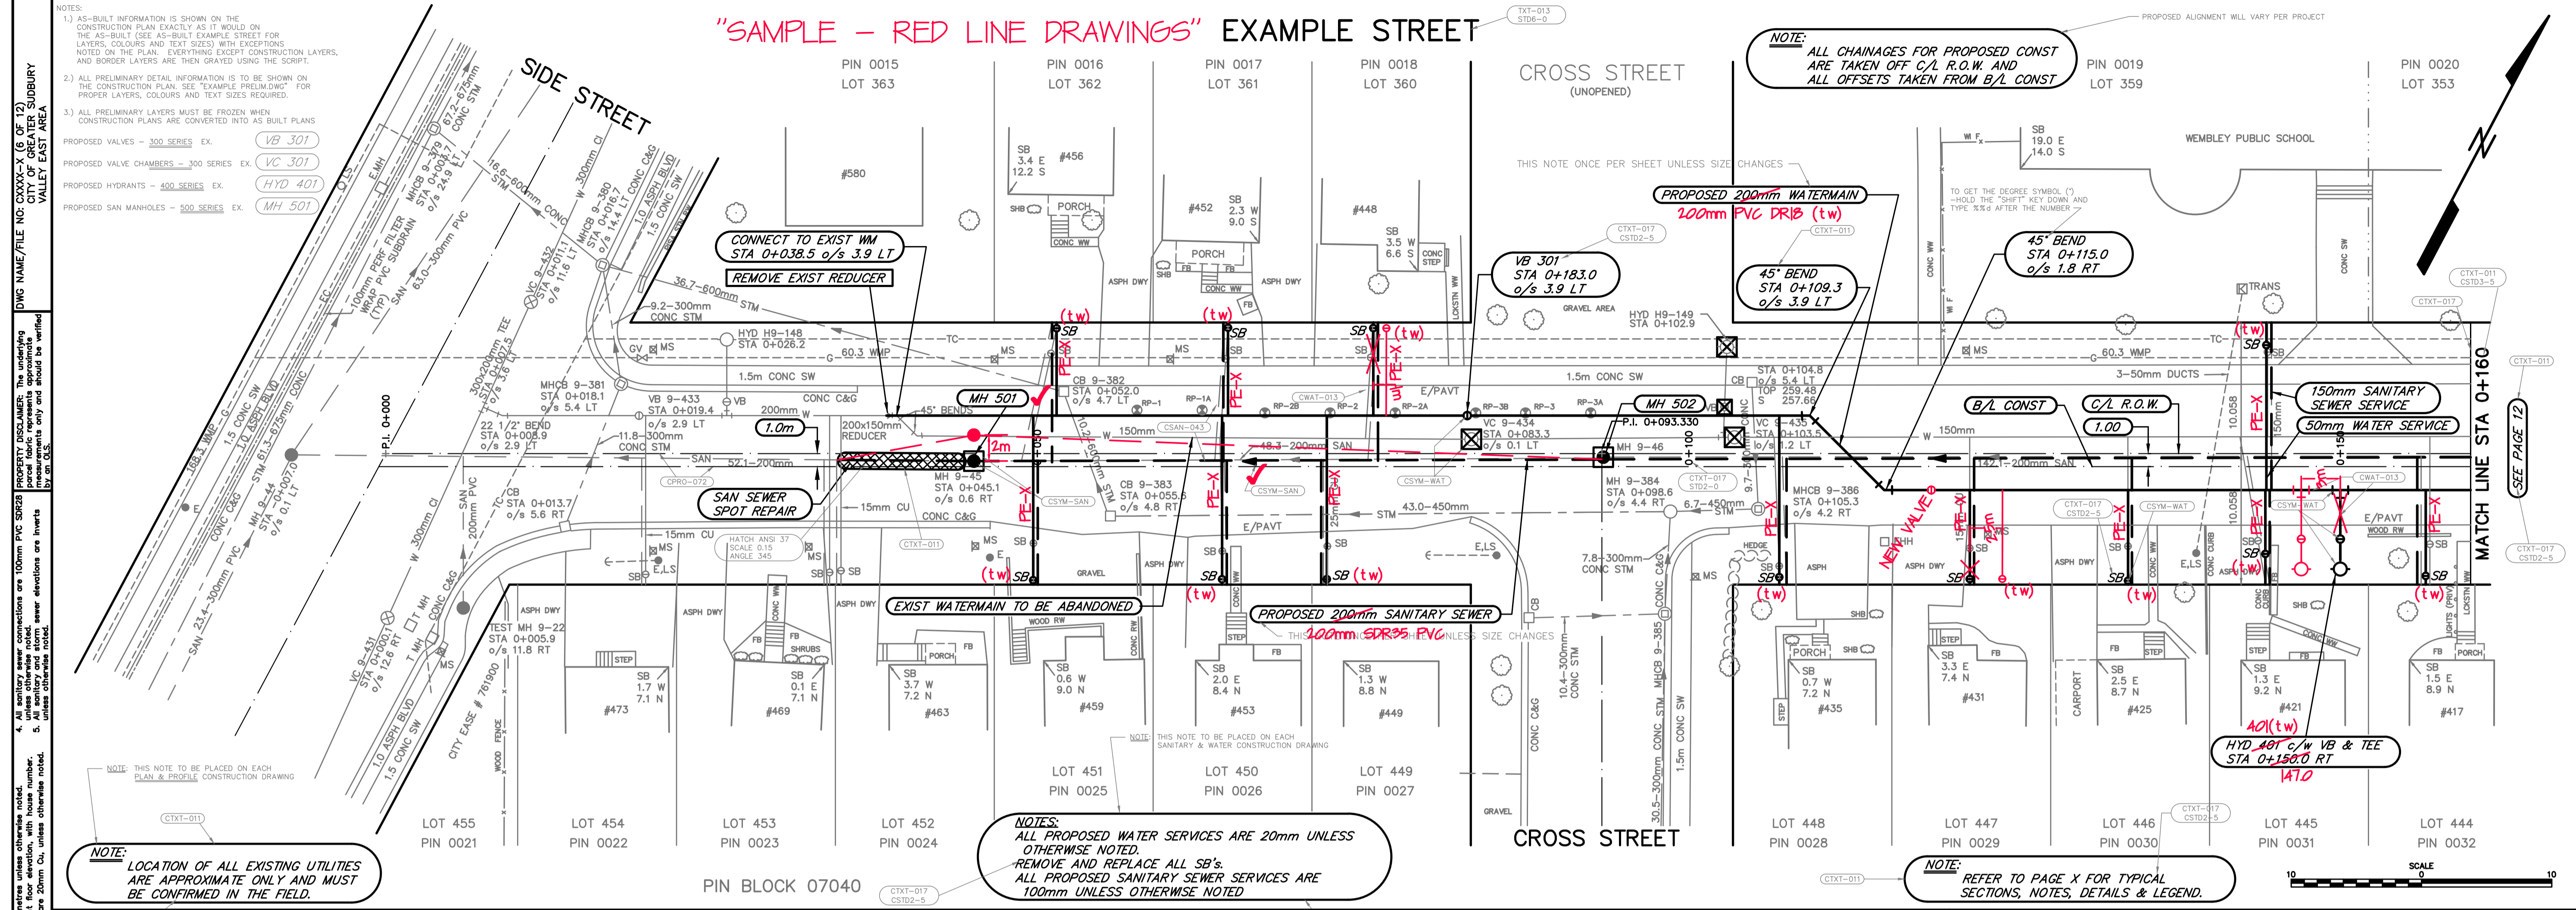

NOTES:
 1.) AS-BUILT INFORMATION IS SHOWN ON THE CONSTRUCTION PLAN EXACTLY AS IT WOULD ON THE AS-BUILT (SEE AS-BUILT EXAMPLE STREET FOR LAYERS, COLOURS AND TEXT SIZES) WITH EXCEPTIONS NOTED ON THE PLAN. EVERYTHING EXCEPT CONSTRUCTION LAYERS, AND BORDER LAYERS ARE THEN GRAYED USING THE SCRIPT.
 2.) ALL PRELIMINARY DETAIL INFORMATION IS TO BE SHOWN ON THE CONSTRUCTION PLAN. SEE "EXAMPLE PRELIM.DWG" FOR PROPER LAYERS, COLOURS AND TEXT SIZES REQUIRED.
 3.) ALL PRELIMINARY LAYERS MUST BE FROZEN WHEN CONSTRUCTION PLANS ARE CONVERTED INTO AS-BUILT PLANS.
 PROPOSED VALVES - 300 SERIES EX. VB 301
 PROPOSED VALVE CHAMBERS - 300 SERIES EX. VC 301
 PROPOSED HYDRANTS - 400 SERIES EX. HYD 401
 PROPOSED SAN MANHOLES - 500 SERIES EX. MH 501


PROPERTY DISCLAIMER: This drawing is a preliminary design and should be verified in the field. All dimensions are in metres unless otherwise noted. All sanitary sewer connections are 100mm PVC SDR35. All watermain connections are 200mm PVC SDR35. All manholes and storm sewer elevations are inverts unless otherwise noted. All manhole and storm sewer elevations are inverts unless otherwise noted. All manhole and storm sewer elevations are inverts unless otherwise noted. All manhole and storm sewer elevations are inverts unless otherwise noted.

NOTE: THIS NOTE TO BE PLACED ON EACH PLAN & PROFILE CONSTRUCTION DRAWING

NOTE: ALL CHAINAGES FOR PROPOSED CONST ARE TAKEN OFF C/L R.O.W. AND ALL OFFSETS TAKEN FROM B/L CONST

NOTE: REFER TO PAGE X FOR TYPICAL SECTIONS, NOTES, DETAILS & LEGEND.

SCALE 1:250 HOR. 1:50 VER.

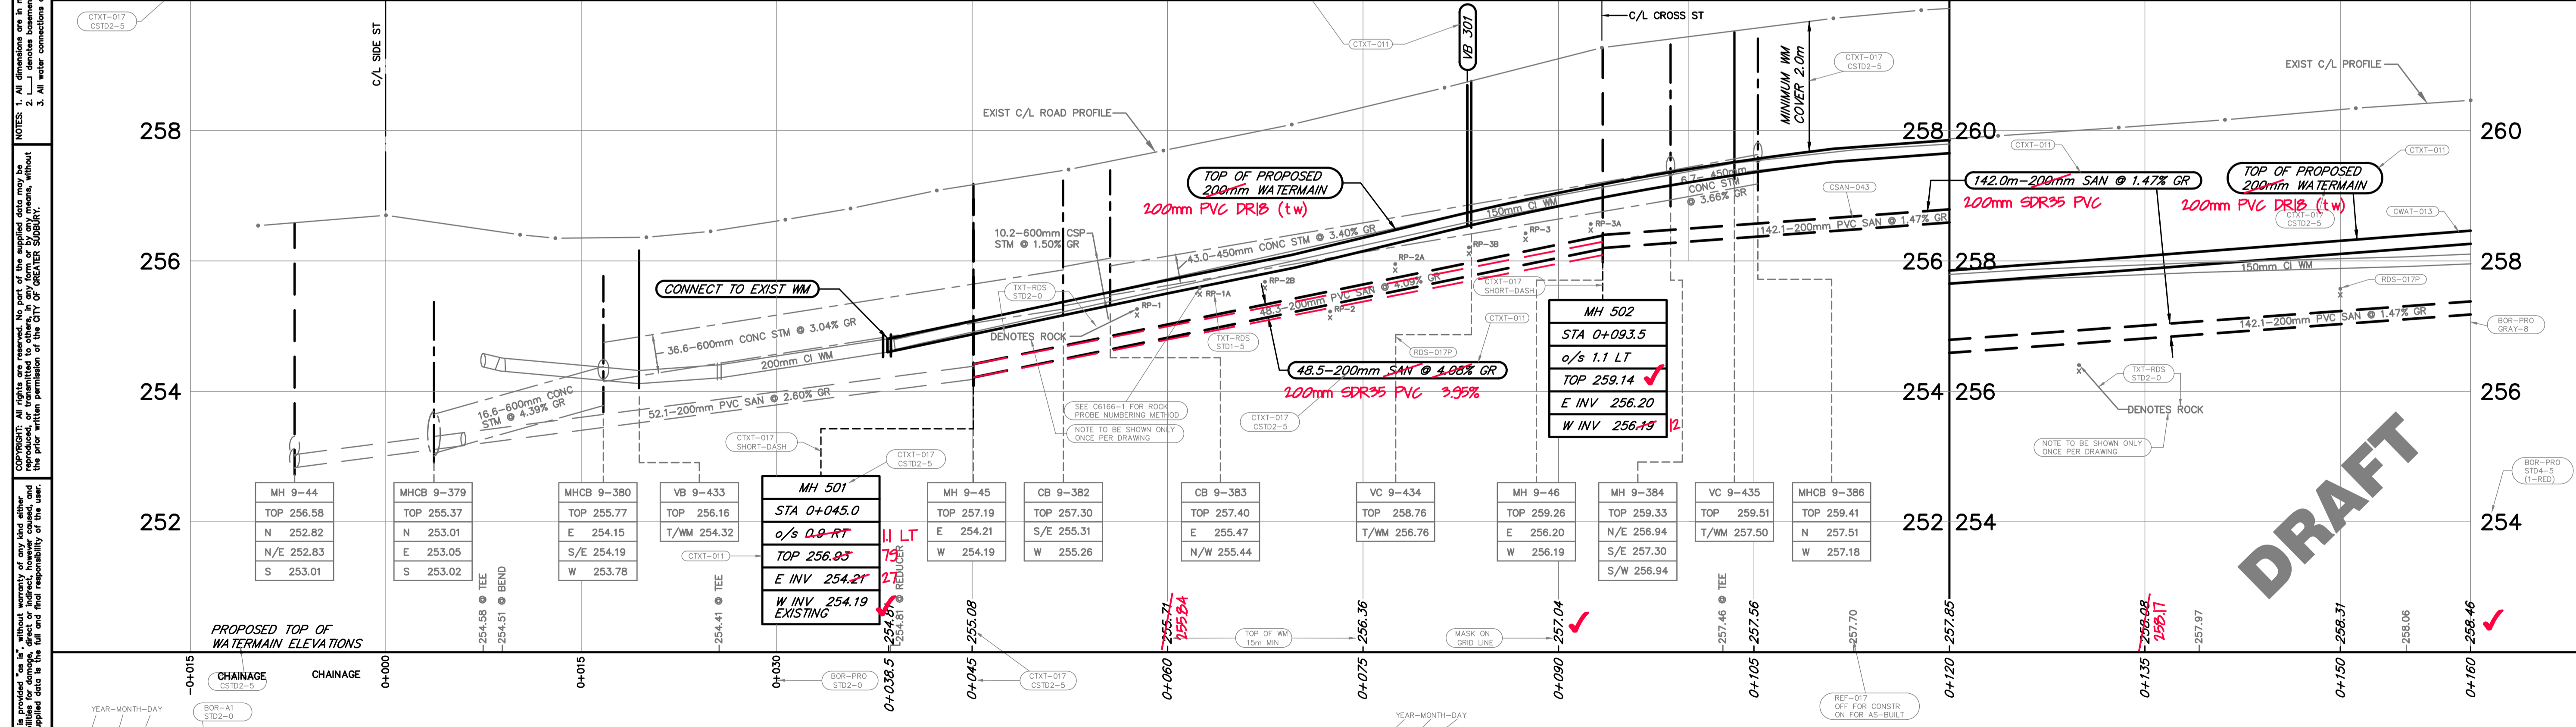

REVISIONS			CAUTION			DATE: 2004-05-23		
DATE	DETAILS	BY	- ALL UTILITIES ARE NOT NECESSARILY SHOWN ON THIS DRAWING. - WHERE UTILITIES ARE SHOWN, LOCATIONS ARE NOT GUARANTEED. - LOCATION & SIZE OF ALL UTILITIES MUST BE VERIFIED IN THE FIELD.			DRAWN:	FJD	
2012-02-14	UPDATED ROCK NOTE IN PROFILE	MHD				CHECKED:		
2016-03-09	ADDED ROCK PROBE NUMBERING CONVENTION	SAG				ENGINEER:		
2017-07-04	UPDATED CHAINAGE TO 15m INTERVAL IN PROFILE	GGV				APPROVED:		
2021-09-14	TURNED OFF PROPERTY FABRIC	RN				Greater Grand Sudbury EXAMPLE STREET STA 0+000 TO STA 0+160 AT CROSS ST VALLEY EAST AREA		
2026-03-18	WATERMAIN AND SANITARY INSTALL DATE	RN						
						CONTRACT NO.: ENXX-XX CAD/FILE NUMBER: CXXX-X PAGE NO.: 6 of 12		