NOTES:
1.) AS-BUILT INFORMATION IS SHOWN ON THE PRELIMINARY BASE PLAN EXACTLY AS IT WOULD ON THE AS-BUILT (SEE AS-BUILT EXAMPLE STREET FOR LAYERS, COLOURS AND TEXT SIZES) WITH EXCEPTIONS NOTED ON THE PLAN.
2.) ALL PRELIMINARY LAYERS ON THIS PLAN MUST BE FROZEN WHEN USED AS AN AS BUILT PLAN.
3.) ALL TEXT ASSOCIATED WITH PRELIMINARY DETAIL SHOULD BE LOCATED ON THE "TXT-PRE" LAYER.

C/L CURVE DATA
P.I. STA 0+051.383
Δ = 23°48'00"
T = 14.741
R = 71.000
L = 29.069
C = 28.867
E = 1.514

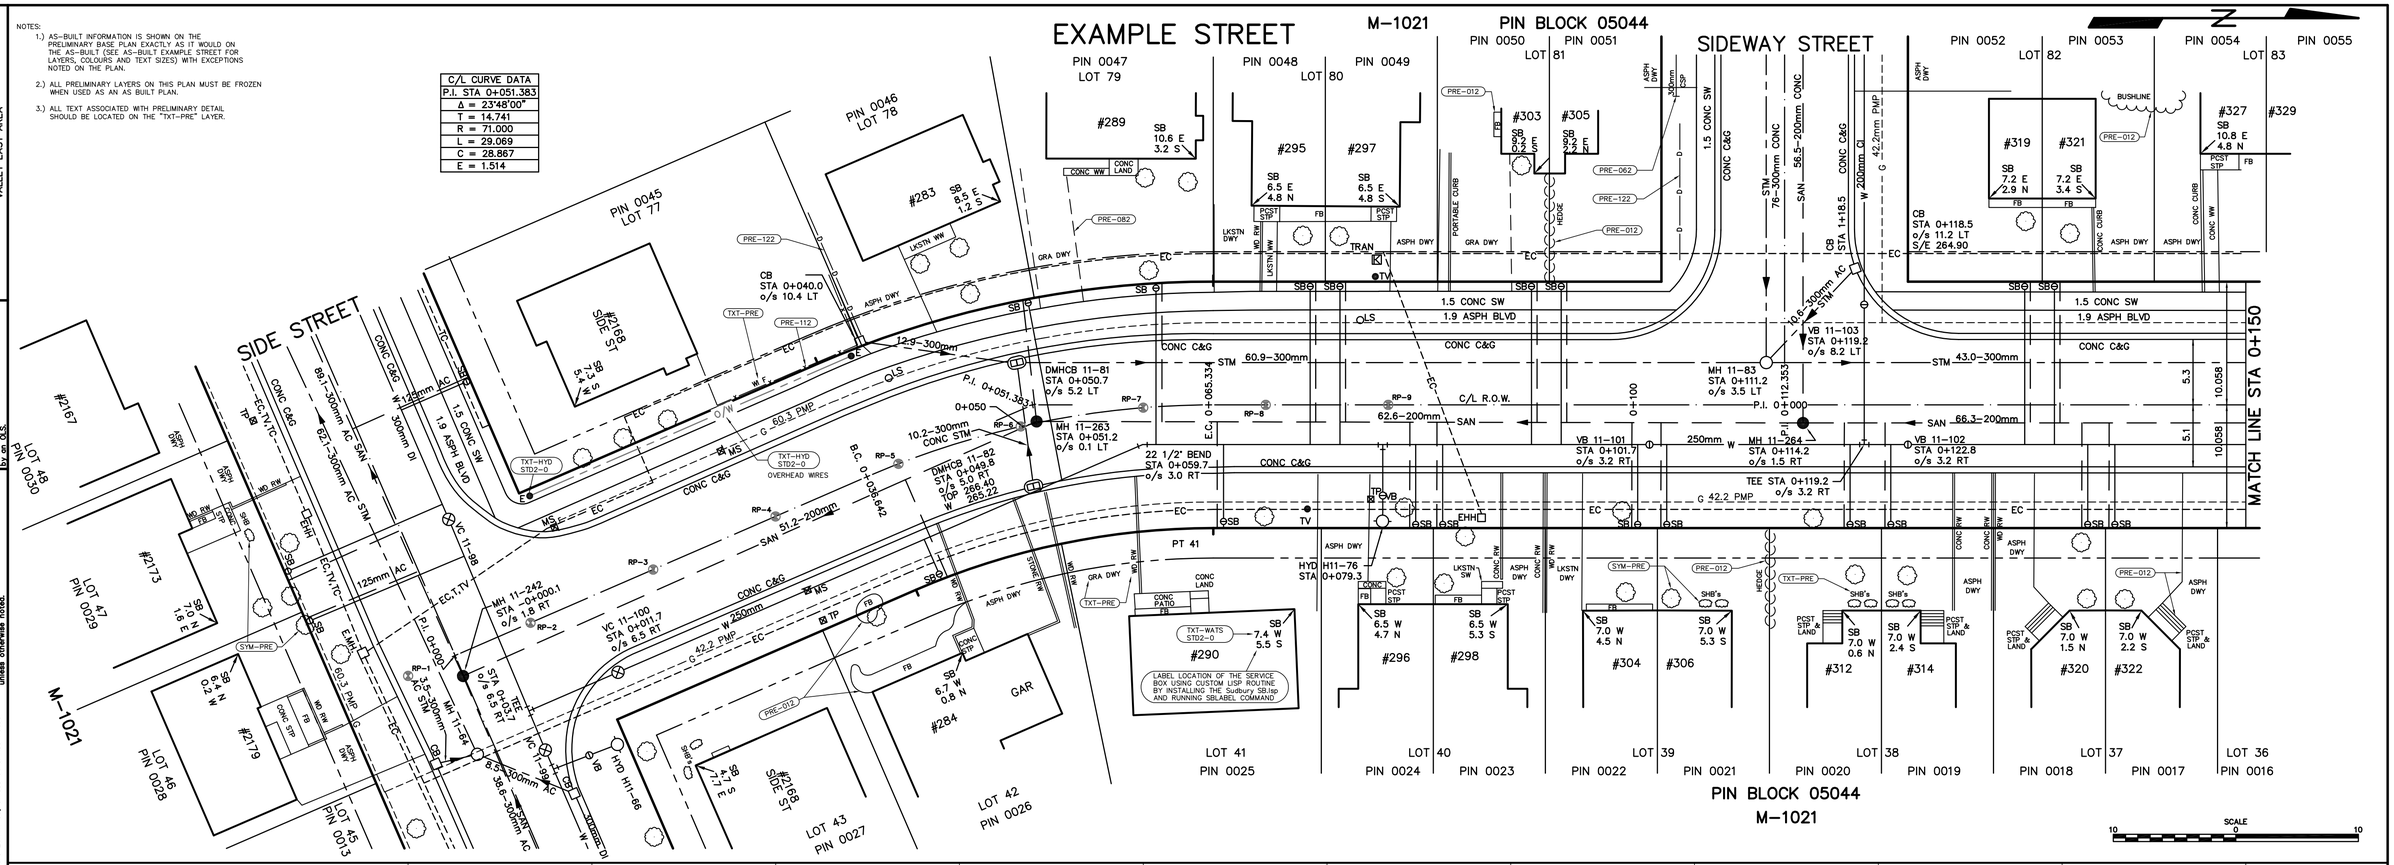

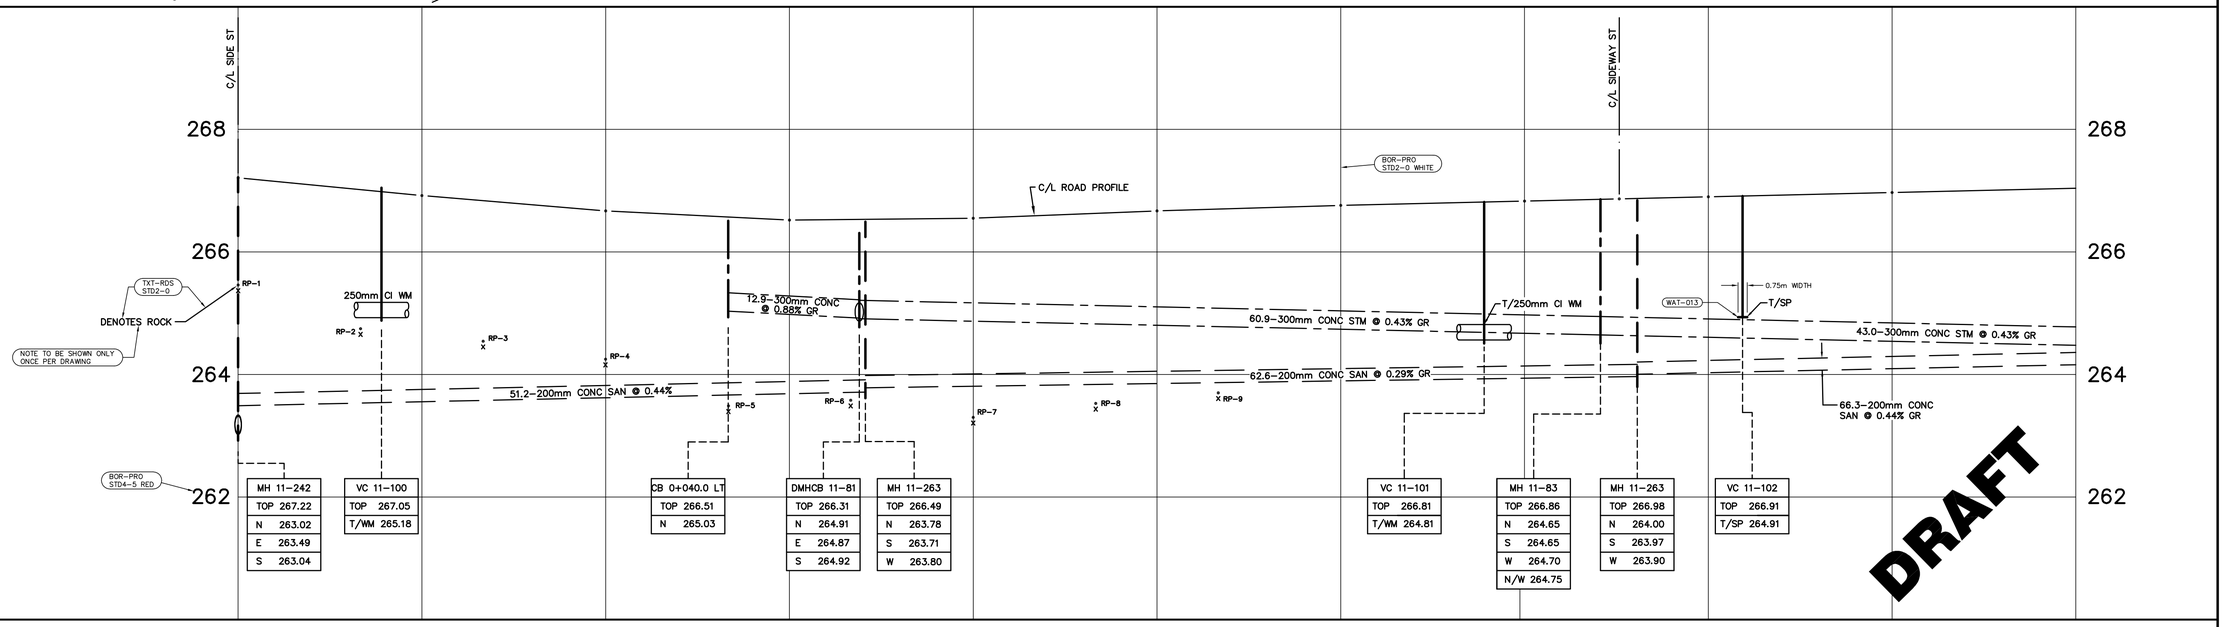

YEAR-MONTH-DAY

REVISIONS

DATE	DETAILS	BY
2012-02-14	UPDATED ROCK NOTE IN PROFILE (DRAFTSPERSON'S INITIALS)	MHD
2014-03-12	CHANGED PROFILE HORIZONTAL GRID LINE SPACING TO 15m INTERVALS	MHD
2016-02-14	CHANGED C/L ROAD PROFILE LABEL	SAG
2018-02-12	ADDED NOTE EXPLAINING HOW TO USE CUSTOM LISP ROUTINE TO LABEL SB	JRC
2021-09-14	TURNED OFF PROPERTY FABRIC	RN

CAUTION

- ALL UTILITIES ARE NOT NECESSARILY SHOWN ON THIS DRAWING.
- WHERE UTILITIES ARE SHOWN, LOCATIONS ARE NOT GUARANTEED
- LOCATION & SIZE OF ALL UTILITIES MUST BE VERIFIED IN THE FIELD.

DATE:	2004-03-23
DRAWN:	FJD
DESIGNED:	
CHECKED:	
ENGINEER:	
APPROVED:	

Greater Grand Sudbury

PRELIMINARY BASE PLAN

EXAMPLE STREET
STA 0+000 TO STA 0+150
AT SIDE ST & SIDEWAY ST
VALLEY EAST AREA

SCALE: 1:250 HOR. 1:50 VER.
CONTRACT NO.:
CAD/FILE NUMBER: Example1B
PAGE NO.: 1 OF 4

DWG NAME/FILE NO: EXAMPLE1B (X OF X)
CITY OF GREATER SUDBURY
VALLEY EAST AREA

PROPERTY DISCLAIMER: The underlying parcel fabric represents approximate measurements only and should be verified by survey.

4. All sanitary sewer connections are 100mm PVC SDR28 unless otherwise noted.
5. All storm sewer elevations are inverts unless otherwise noted.

NOTES: 1. All dimensions are in metres unless otherwise noted.
2. ⊔ denotes basement floor elevation, with house number.
3. All water connections are 20mm Cu, unless otherwise noted.

COPYRIGHT: All rights are reserved. No part of the supplied data may be reproduced, or transmitted to others, in any form or by any means, without the prior written permission of the CITY OF GREATER SUDBURY.

DISCLAIMER OF WARRANTY: The data is provided "as is", without warranty of any kind either expressed or implied. Any and all liabilities for damage, direct or indirect, however caused, and resulting in any way by use of the supplied data is the full and final responsibility of the user.